
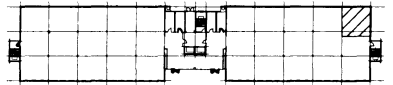


12

13

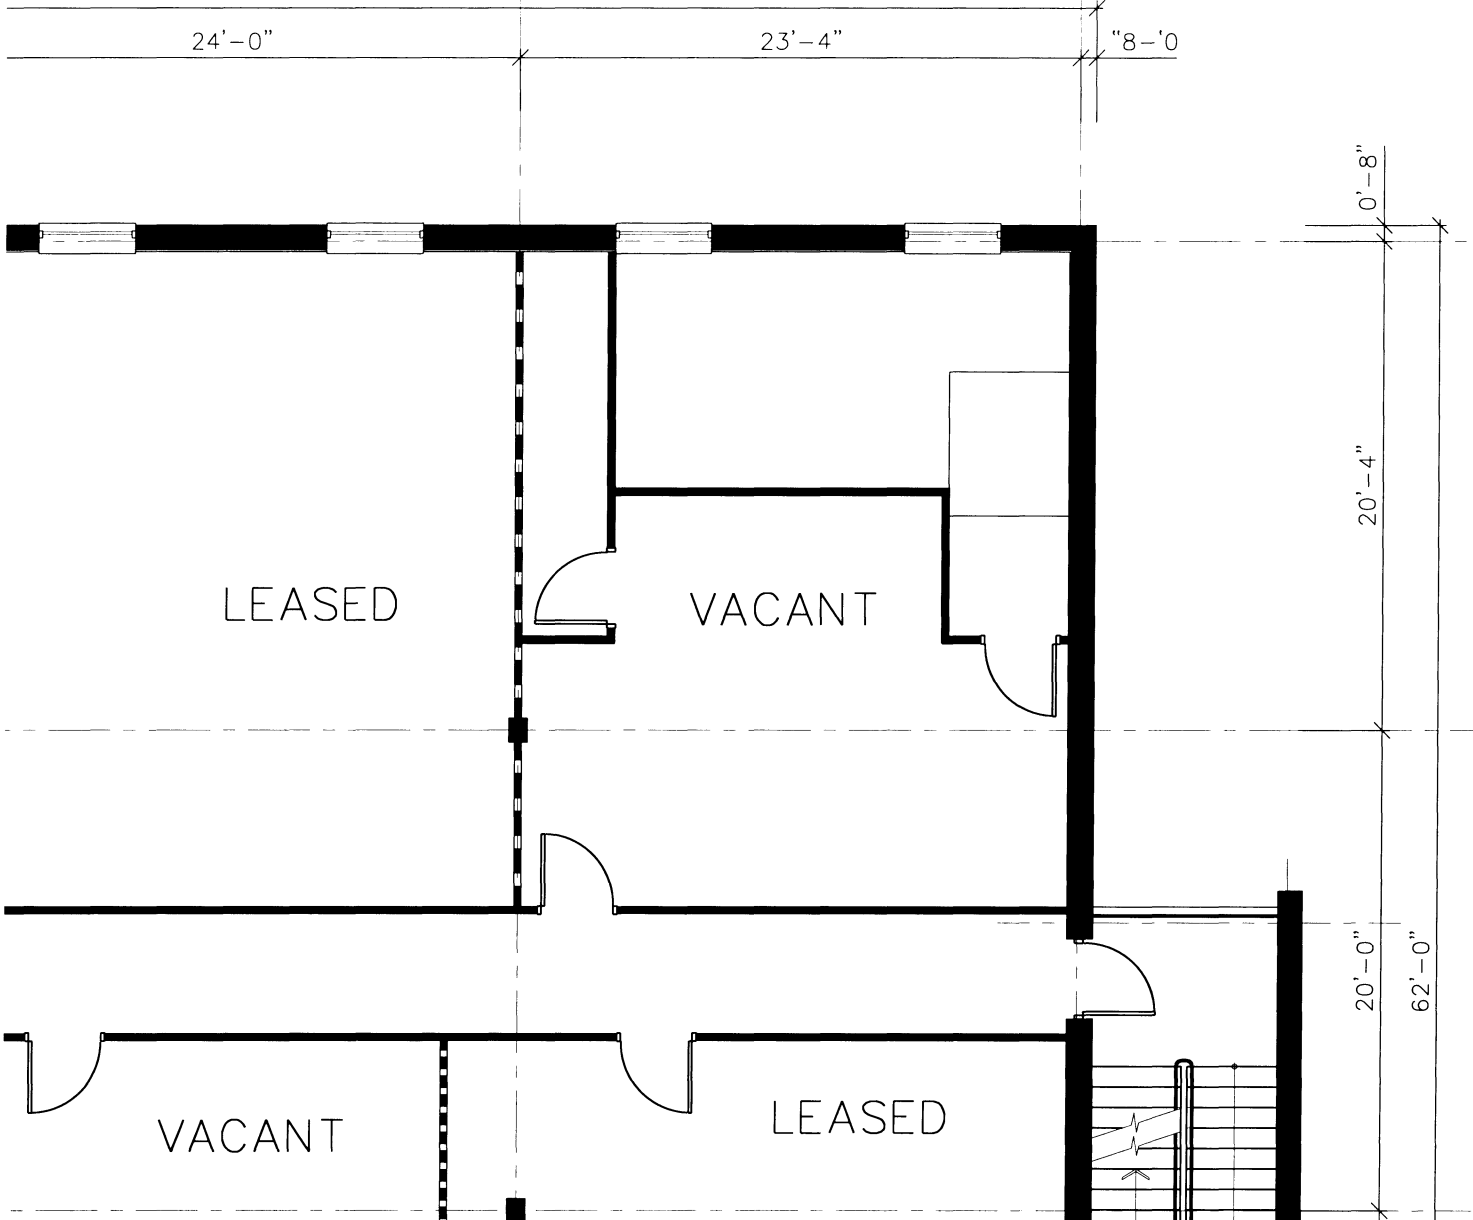

KEY PLAN

E:\VACAD\1103\EXTEN\1b03V6.dwg

1B03V6

**A L F I E R I**

PROJECT: AS BUILT PLAN  
MORRIS PLAZA I - 3RD FLR. EAST  
2401 MORRIS AVENUE  
UNION, NEW JERSEY

JOB NO. IBREHAB

SCALE: 1/8"=1'-0"

DATE: 04/13/05